
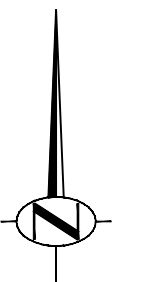


Location Map

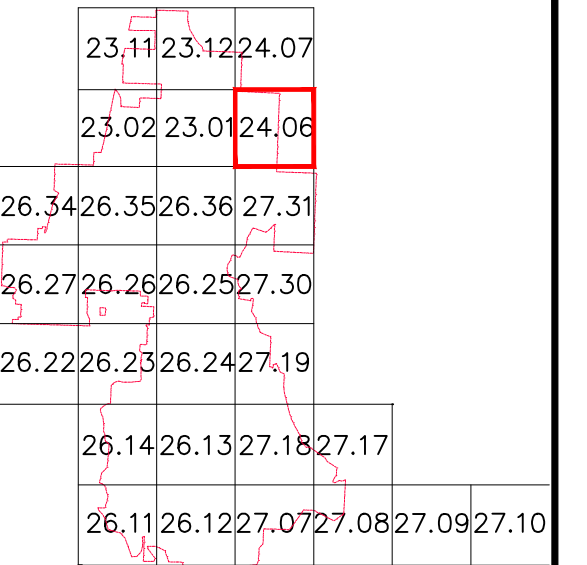

AF CONSULTING
Water & Environmental Engineering

1"=100' AS-BUILT MAPS

26A	39A
26C	40
27	43
32	43A
33	44
34	45
35	46
35A	47
35B	48
39	51B

Legend

- 150mm CL 150 A.C. DRY WATERMAIN c/w SIZE, CLASS & MATERIAL
- 150mm CL 150 A.C. IRRIGATION WATERMAIN c/w SIZE, CLASS & MATERIAL
- 150mm CL 150 A.C. DOMESTIC WATERMAIN c/w SIZE, CLASS & MATERIAL
- DOUBLE 19mm DOMESTIC SERVICE DISTANCE IN METERS
- 19mm DOMESTIC SERVICE
- 25mm IRRIGATION SERVICE
- 38mm IRRIGATION SERVICE
- 50mm IRRIGATION SERVICE
- 65mm IRRIGATION SERVICE
- 75mm IRRIGATION SERVICE
- GATE VALVE
- P.R.V. VALVE STN.#
- BOOSTER PUMP STATION
- 150/100 WATERLINE REDUCER (mm)
- HYDRANT
- AIR VALVE
- BLOW OFF
- CAP
- PROPERTY LINE OFFSET (m)
- IRON PIN
- CHECK VALVE

Scale 1:2500

Date APR 2016



Drawn A. FACCIANI

- Any services without dimensions are assumed to be located at the centre of the property.
- Hydrants are shown without valves.
- AF Consulting prepared the drawings based on best available information provided by BMID. AF Consulting accepts no responsibility for the accuracy of this drawing.

Revisions

5	DWG. UPDATE	APR 2016
4	DWG. UPDATE	OCT 2013
3	DWG. UPDATE	MAY 2009
2	DWG. UPDATE	MARCH 2006
1	TO METRIC	APRIL 2005

This plan is not a legal document and is for general information only.

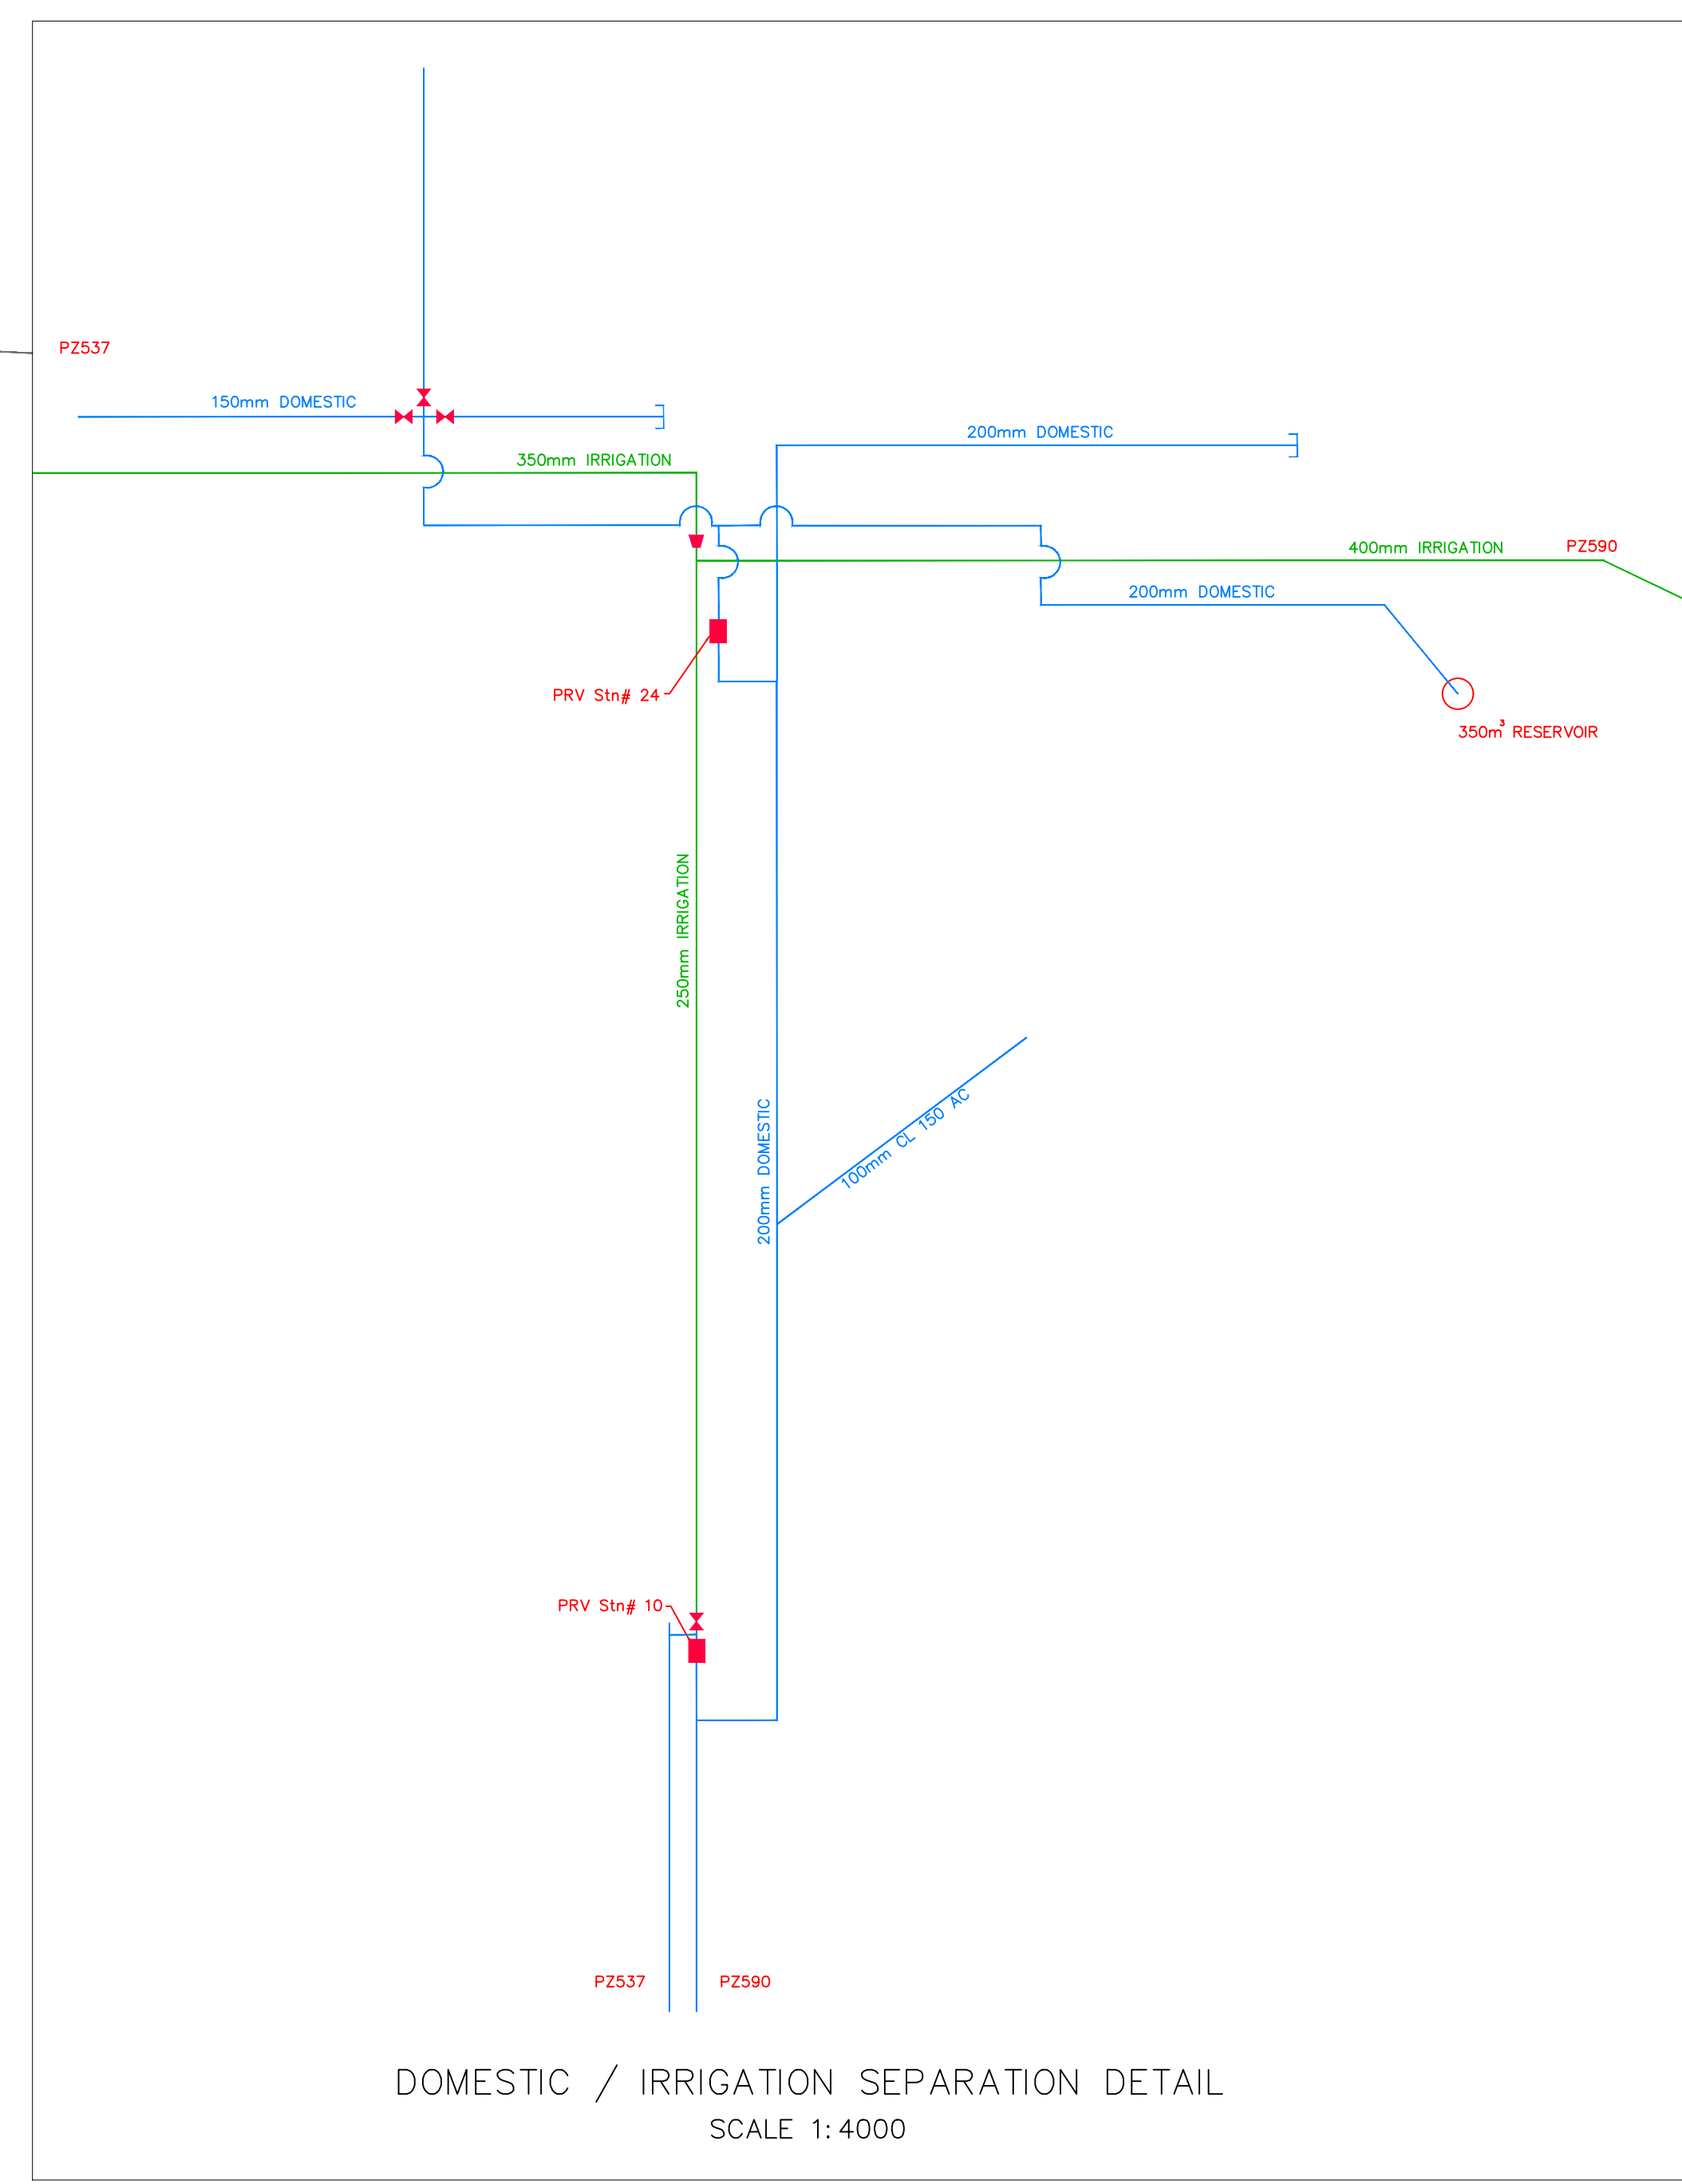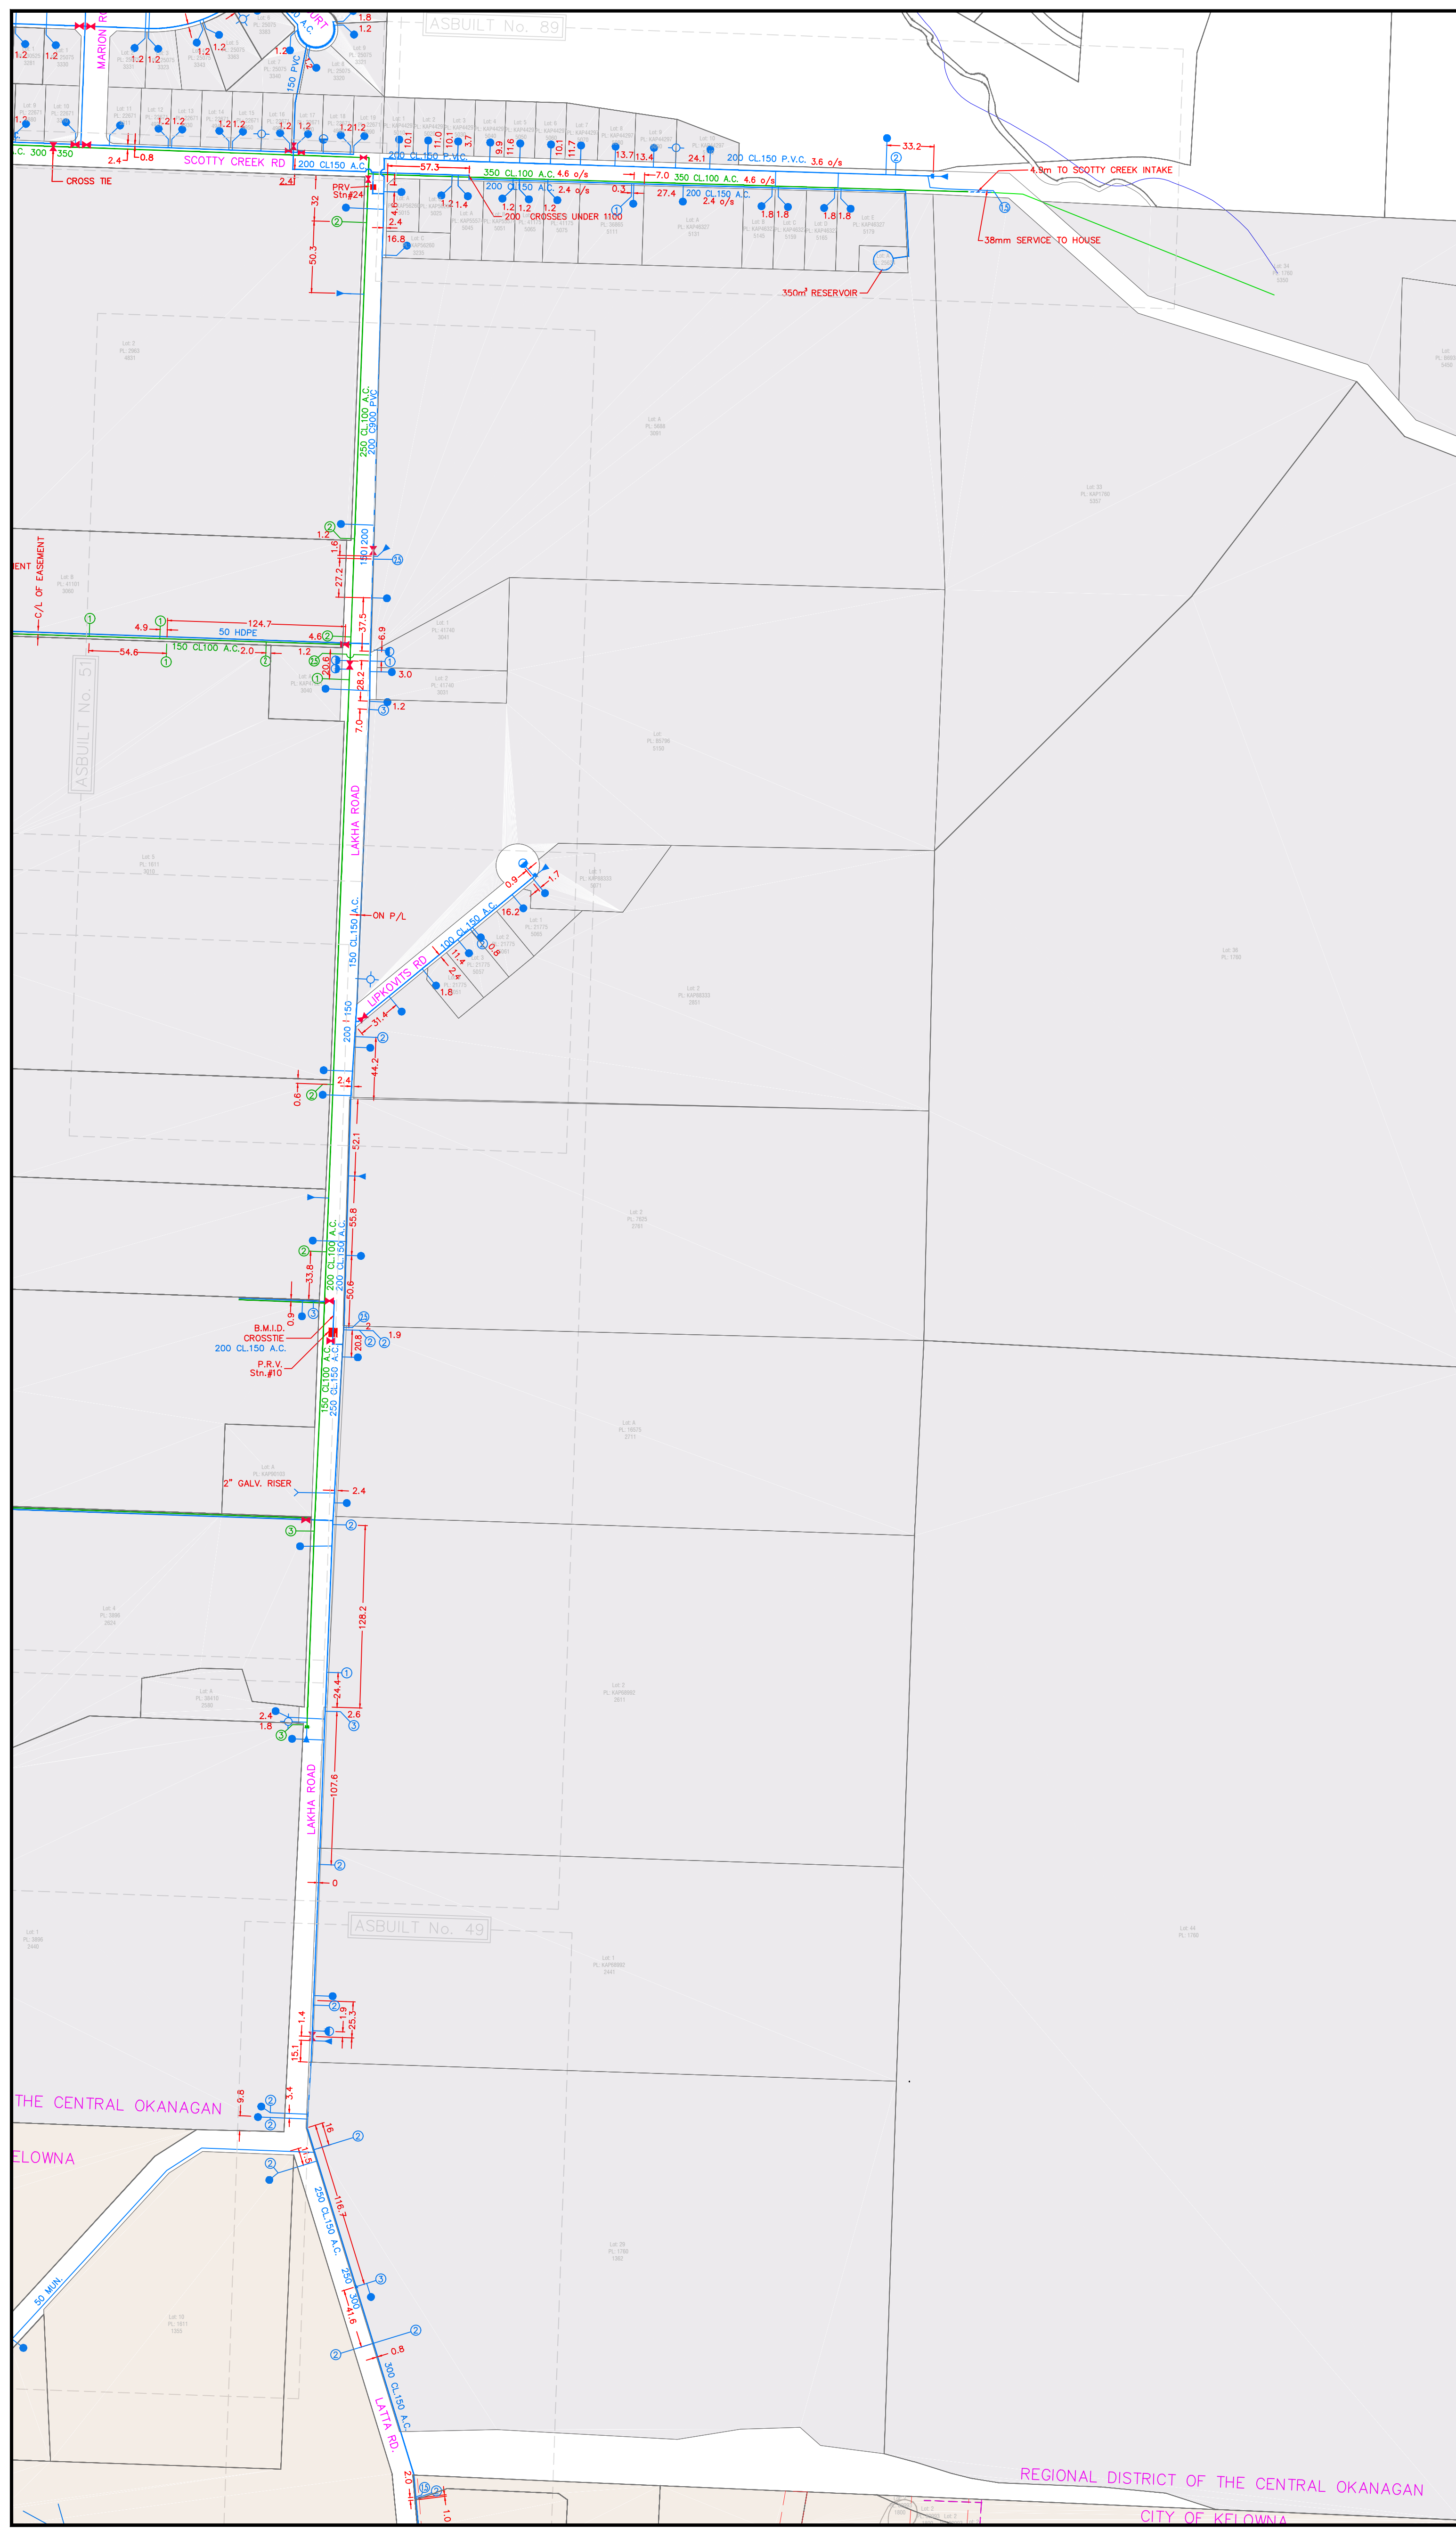

DOMESTIC / IRRIGATION SEPARATION DETAIL
SCALE 1:4000