
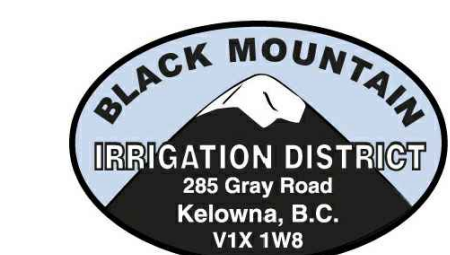
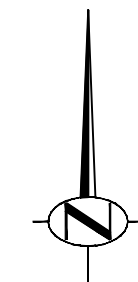


Location Map

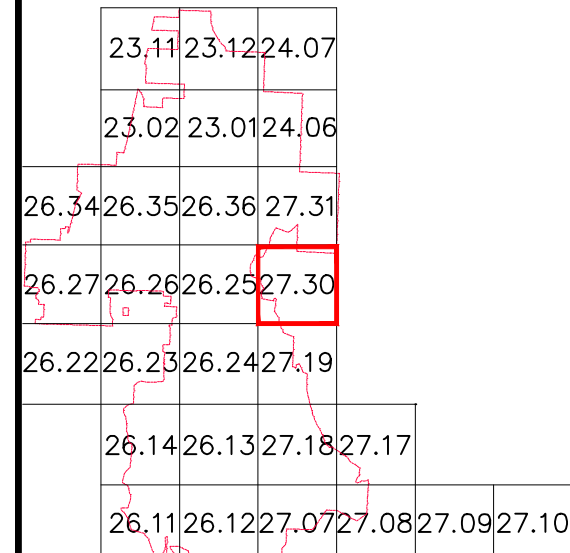

1"=100' AS-BUILT MAPS

54
54A

Legend

- 150mm CL 150 A.C. DRY WATERMAIN c/w SIZE, CLASS & MATERIAL
- 150mm CL 150 A.C. IRRIGATION WATERMAIN c/w SIZE, CLASS & MATERIAL
- 150mm CL 150 A.C. DOMESTIC WATERMAIN c/w SIZE, CLASS & MATERIAL
- DOUBLE 19mm DOMESTIC SERVICE DISTANCE IN METERS
- 19mm DOMESTIC SERVICE
- 25mm IRRIGATION SERVICE
- 38mm IRRIGATION SERVICE
- 50mm IRRIGATION SERVICE
- 65mm IRRIGATION SERVICE
- 75mm IRRIGATION SERVICE
- GATE VALVE
- P.R.V. VALVE STATION
- B.P. BOOSTER PUMP STATION
- 150/100 WATERLINE REDUCER (mm)
- HYDRANT
- AIR VALVE
- BLOW OFF
- CAP
- PROPERTY LINE OFFSET (m)
- IRON PIN
- CHECK VALVE

Scale 1:2500

Date APR 2016


Drawn A. FACCIANI

1. Any services without dimensions are assumed to be located at the centre of the property.
2. Hydrants are shown without valves.
3. AF Consulting prepared the drawings based on best available information provided by BMID. AF Consulting accepts no responsibility for the accuracy of this drawing.

Revisions

5	DWG. UPDATE	APR 2016
4	DWG. UPDATE	OCT 2013
3	DWG. UPDATE	MAY 2009
2	DWG. UPDATE	MARCH 2006
1	TO METRIC	APRIL 2005

This plan is not a legal document and is for general information only.

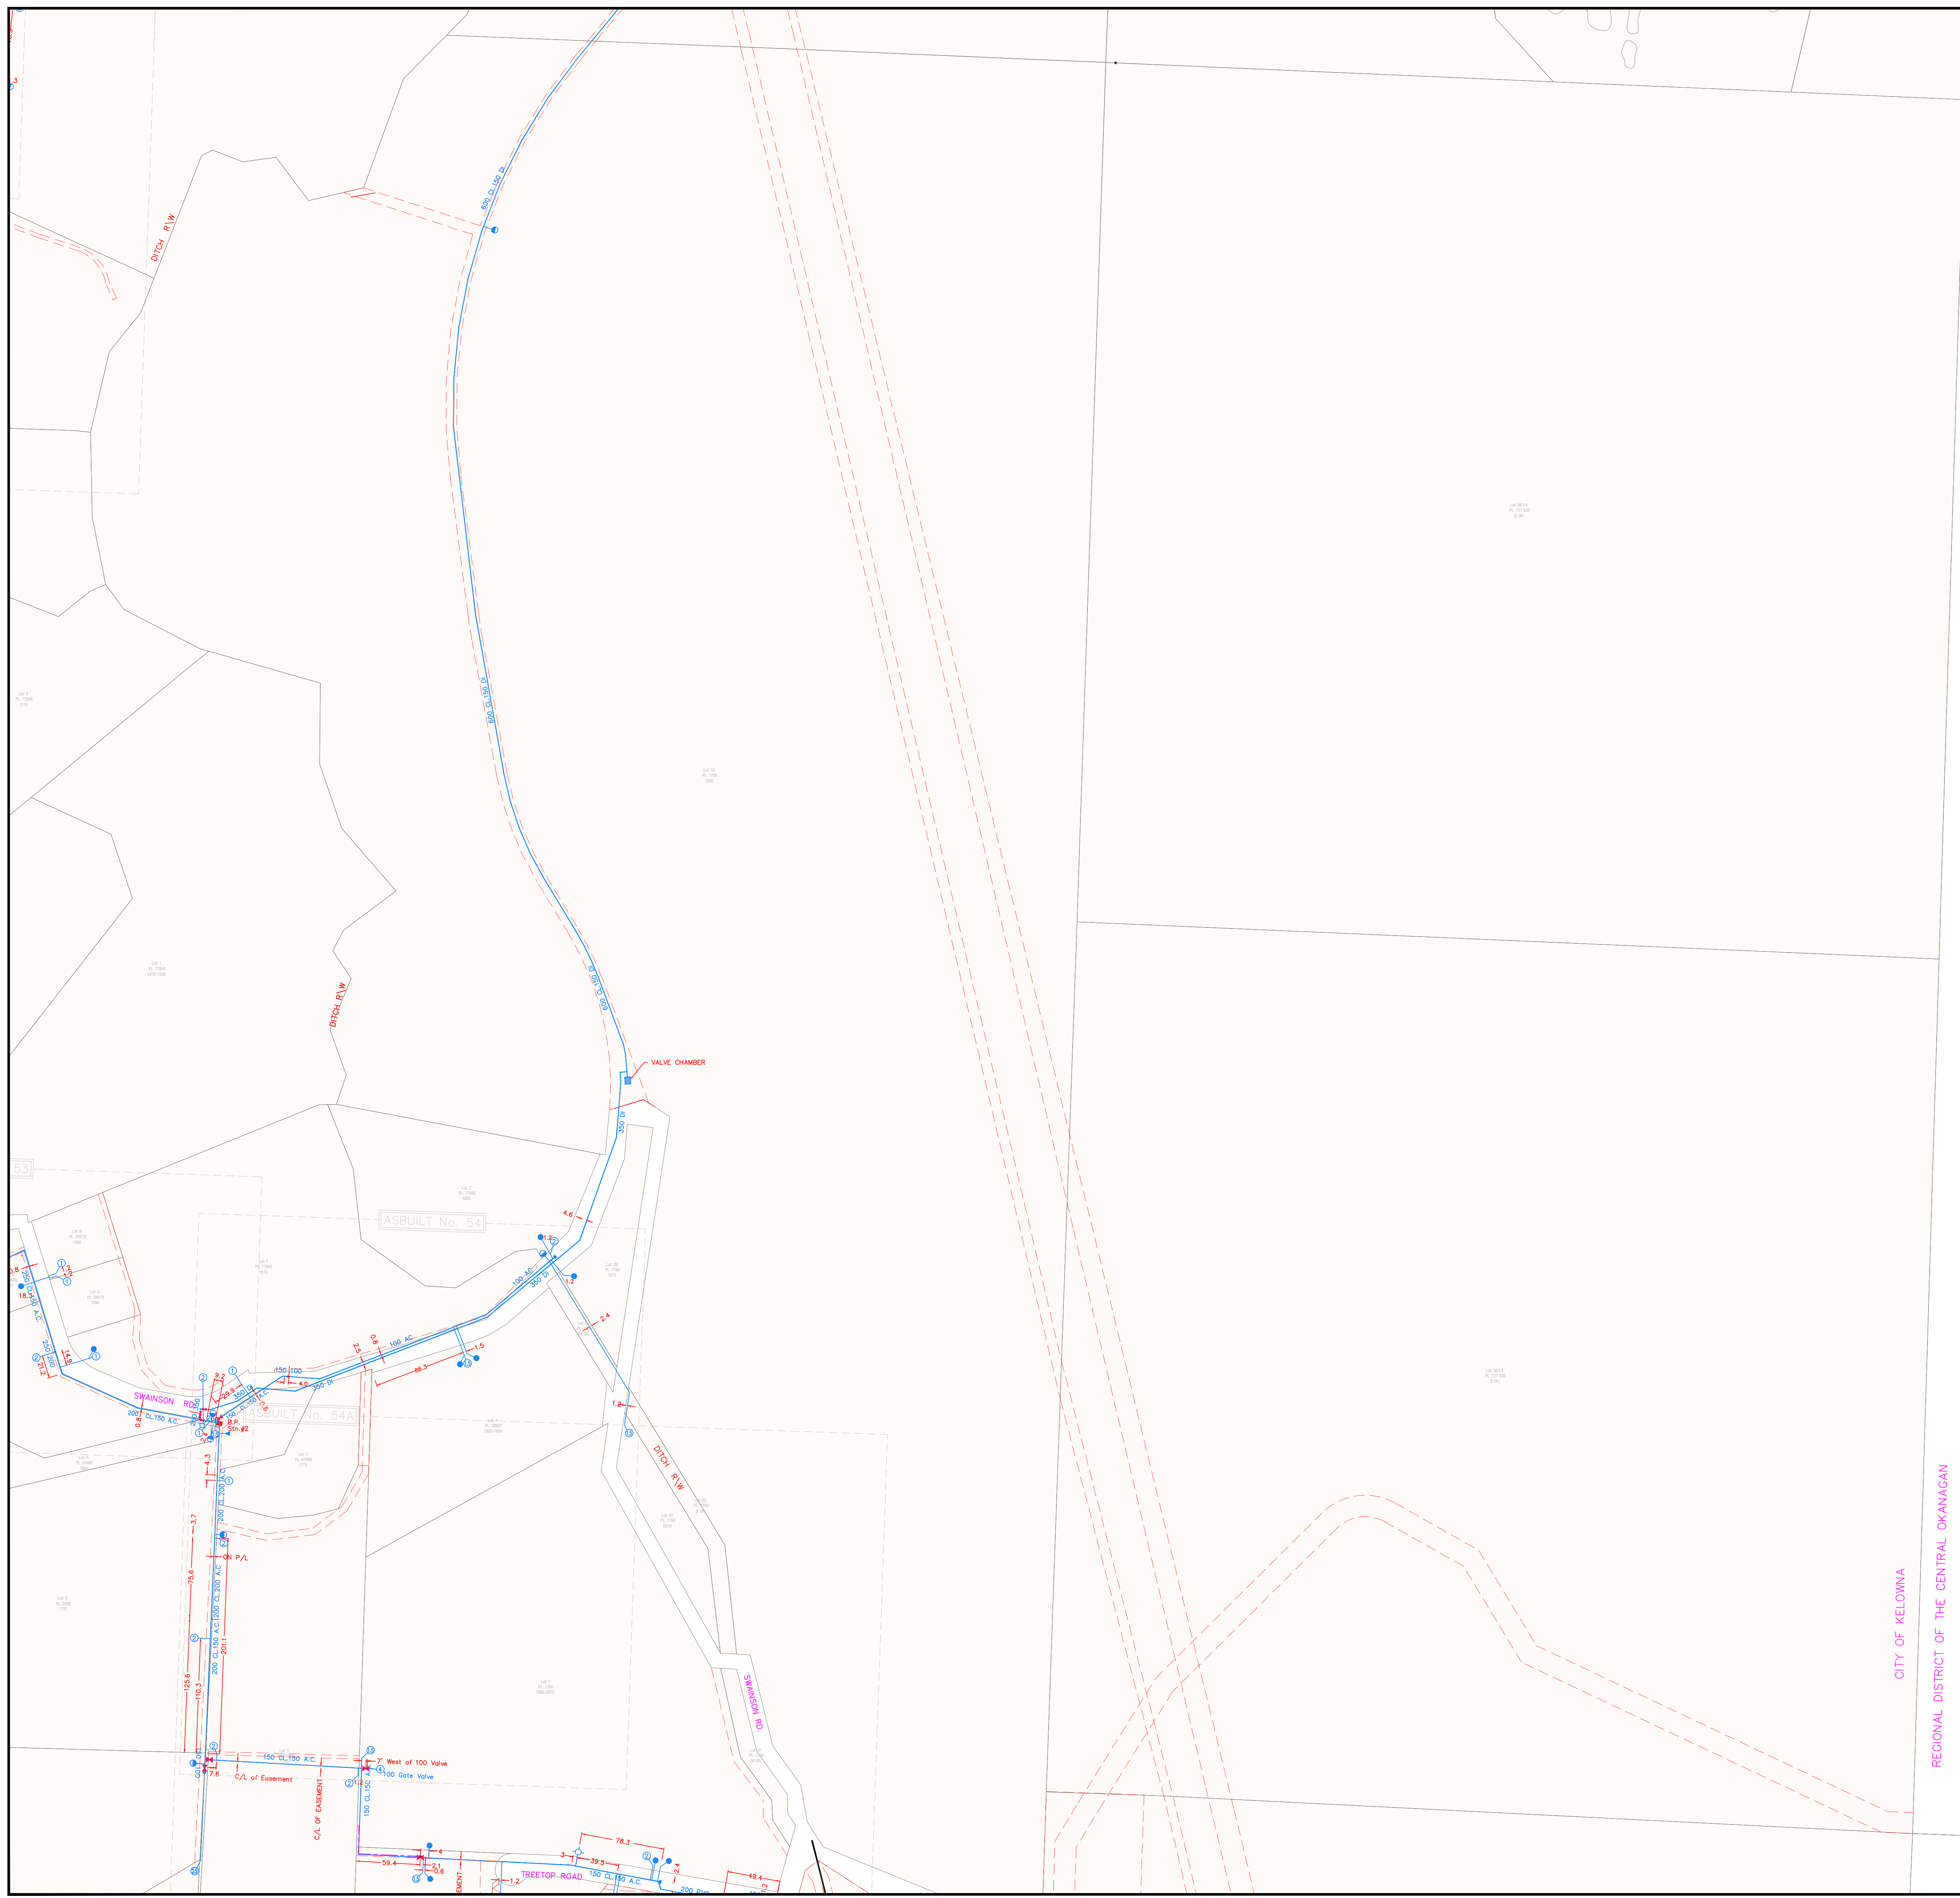

CITY OF KELOWNA
REGIONAL DISTRICT OF THE CENTRAL OKANAGAN